

**Town of Killington**  
**Application for Access (Driveway) to a Town Highway/ 911 Address**

**Application Fee: \$125**

**Recording Fee: \$15 per page**

Owner(s) of Property Alan Withall Telephone (262)3890532

Mailing Address 8917 old river rd unit 4 North Bergen NJ 07047

Applicants Name (if different) \_\_\_\_\_ Telephone \_\_\_\_\_

Mailing Address \_\_\_\_\_

Town Road Name Coffee House Rd. Town Highway # HWY 100

Parcel ID 2-67-3 Road Frontage of Parcel (ft) N/A landlocked

Proposed Use of Curb Cut (check as many as apply):

- |                                      |   |                                     |   |
|--------------------------------------|---|-------------------------------------|---|
| <input type="checkbox"/> Agriculture | <input checked="" type="checkbox"/> Residential | <input type="checkbox"/> Commercial | <input type="checkbox"/> Development Road |
| <input type="checkbox"/> Alteration  | <input type="checkbox"/> Relocation             | <input type="checkbox"/> Use Change | <input type="checkbox"/> Other _____      |

Describe the exact location of the proposed access (distance from property lines, distance to nearby landmarks, etc.):

Property access through right of way (50' wide).  
Located South East corner of Tennis Court on Lot 1,  
neighboring property.

On the back of this sheet, or on a separate sheet, please provide a sketch of the parcel and road frontage indicating the location of the proposed driveway access, other existing accesses, the Town highway, drainage/ditches, trees, buildings, etc.

Please indicate by checking the boxes below that you acknowledge and accept the following:

- I acknowledge and agree that the property owner shall be responsible for the costs of installing and maintaining any driveway culvert, ditch, or other improvements required as a condition of this curb cut approval unless otherwise agreed by the Town in writing.
- I acknowledge and agree that an E-911 Address will be assigned to the property and authorize the Town of Killington to act as my (our) agent on applying for an E-911 Physical Address.

**For Town Use Only**

Application # \_\_\_\_\_ Date Received 3/18/2024

**Town of Killington**  
**Approval of Access to a Town Highway/ 911 Address**

Application Number \_\_\_\_\_ Date of Issuance \_\_\_\_\_

Property Owner: Alan Withall

Applicant (if different) \_\_\_\_\_

Town Road Name & # 480 Coffee House Road

Approved Use(s) Residential

Road Foreman/Public Works Director: I recommend  approval  denial of the above application for the following reasons or subject to the following conditions:

No conditions.

Name Rich Bowen Signature Rich Bowen Date 3/21/24

Fire Chief: I recommend  approval  denial of the above application for the following reasons or subject to the following conditions:

No conditions.

Name Craig R Bowman Signature C.R.B. Date 4/11/24

Approved by the Town of Killington Selectboard on this \_\_\_\_\_ day of \_\_\_\_\_, \_\_\_\_\_


\_\_\_\_\_  
Selectboard Chair Signature

**Inspection is required after completion of work.**

Inspected by \_\_\_\_\_ Date \_\_\_\_\_

**Notice:** This permit is issued in accordance with Title 19, Section 1111, VSA relative to all highways within the control of jurisdiction of the Town of Killington. The issuance of this permit does not release the applicant from any requirements of statute ordinances, rules and regulations administered by other governmental agencies. The permit will be effective upon compliance with such of these requirements as are applicable and continue in effect as long as the present land use continues. Any change from the present land use will require a new permit. This permit is issued subject to the directions, restrictions and conditions contained herein and on the next page of this form and any attachments hereto, and covers only the work described in this application, and then only when the work is performed as directed. Violations are subject to the penalties set forth in Title 19, Section 1111, VSA of fines of not less than \$100.00 nor more than \$10,000.00 for each violation.

**Construction must be completed within 2 years of the approval date of this application.**

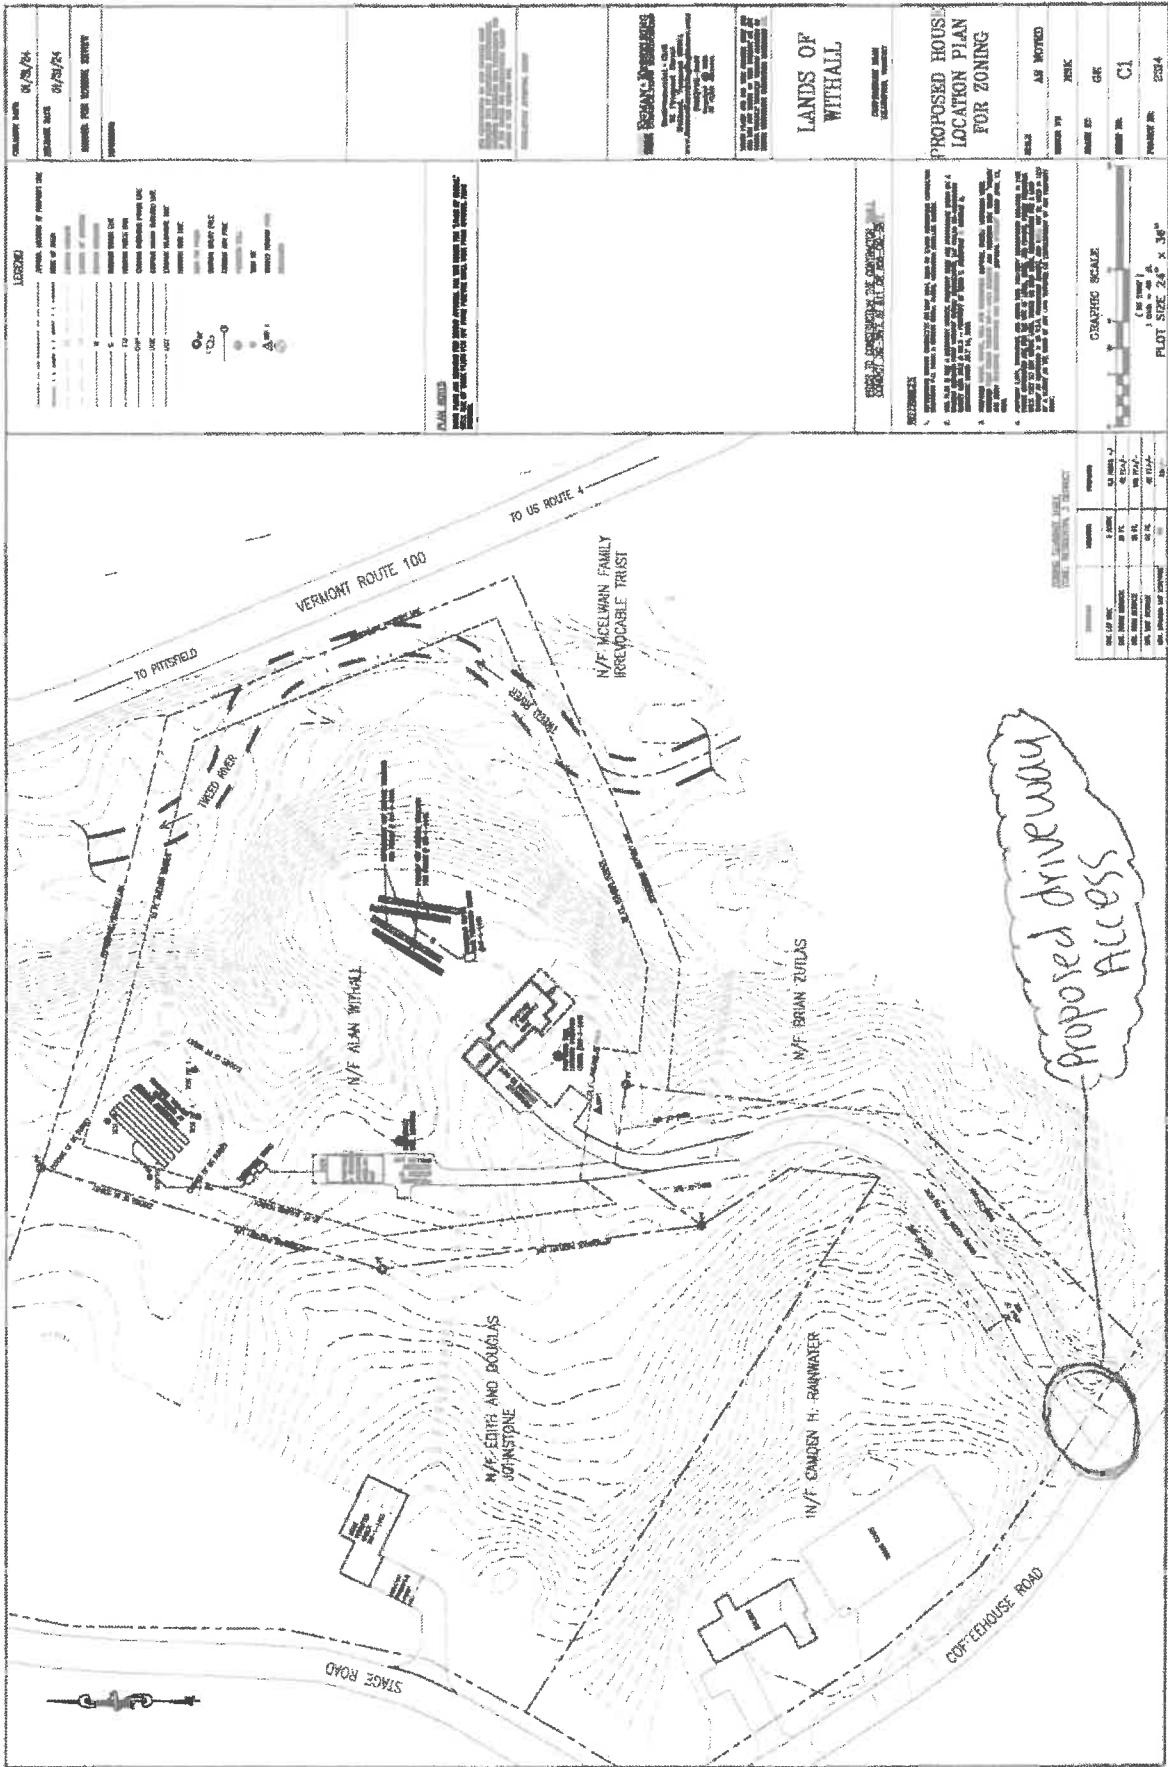

**LEGEND**

PROPOSED HOUSE LOCATIONS

EXISTING HOUSE LOCATIONS

EXISTING DRIVEWAYS

EXISTING ROADS

EXISTING PROPERTY BOUNDARIES

EXISTING CONTOUR LINES

EXISTING UTILITIES

EXISTING VEGETATION

EXISTING WATER BODIES

EXISTING ELEVATION SPOTS











































































**PROPOSED HOUSE LOCATION PLAN FOR ZONING**





PLOT SIZE: 24" x 36"